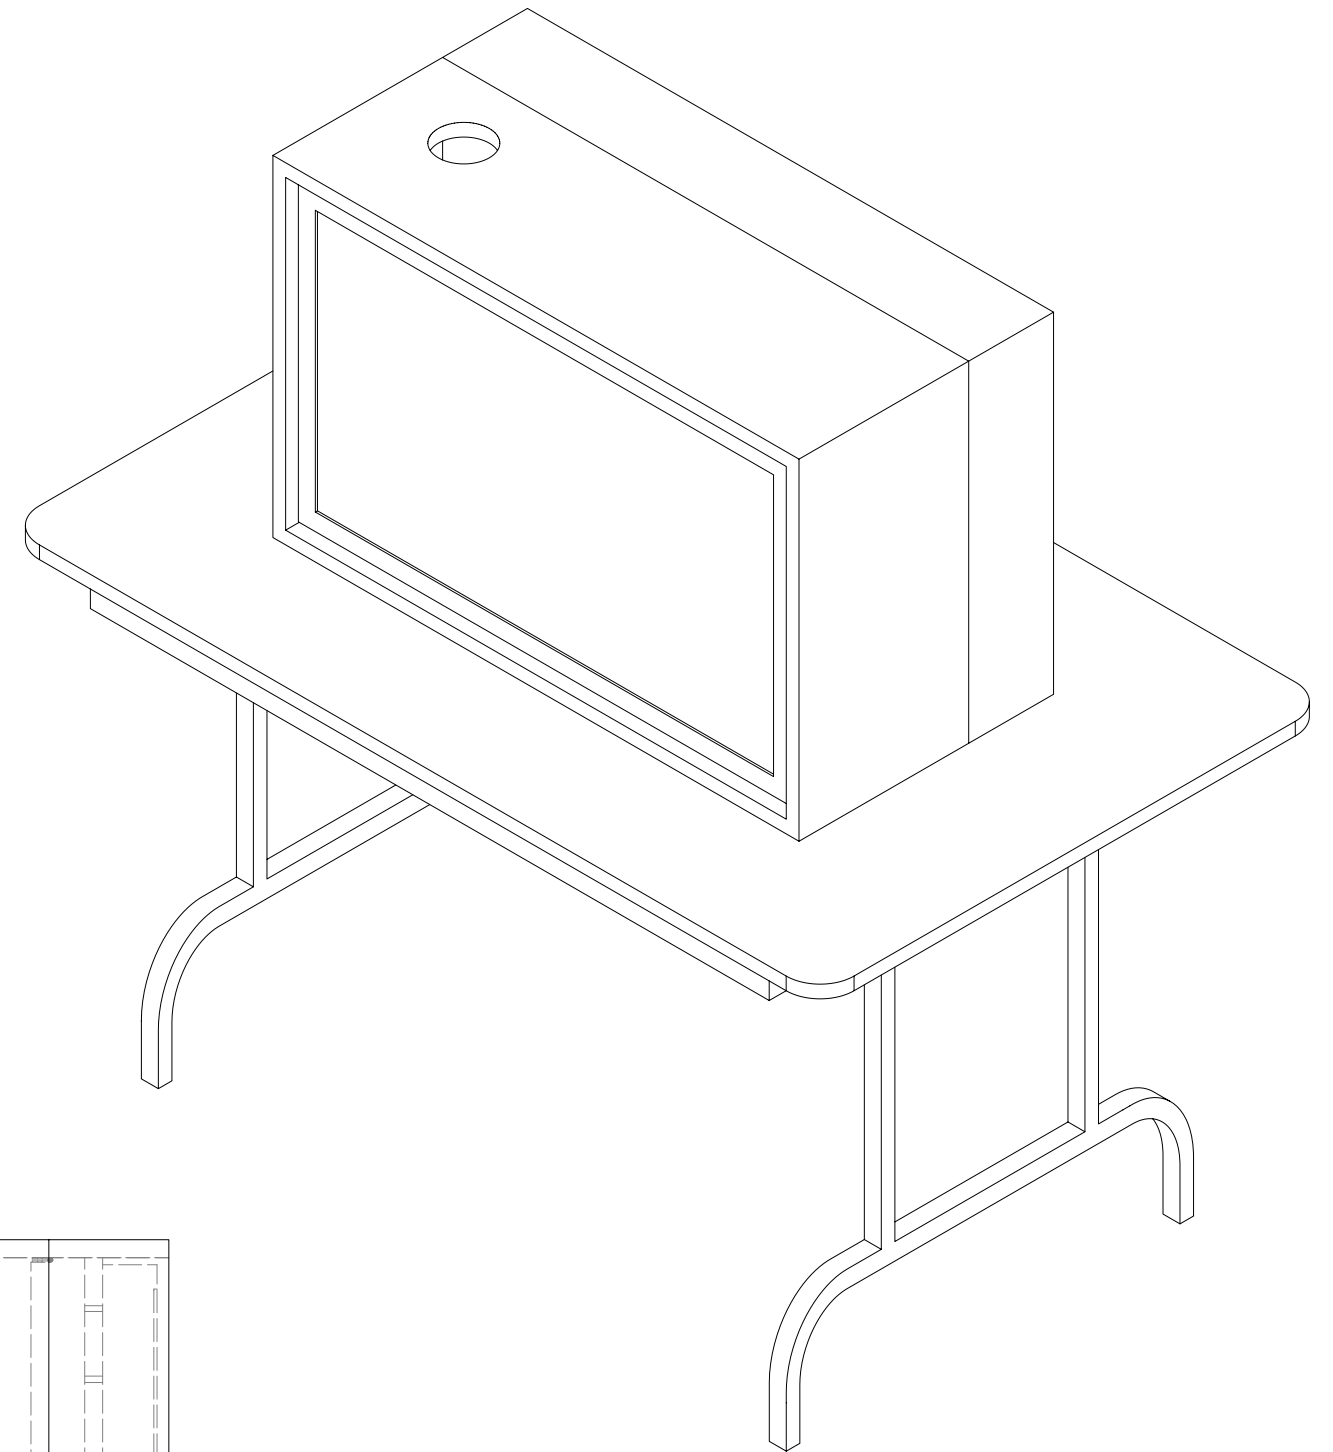
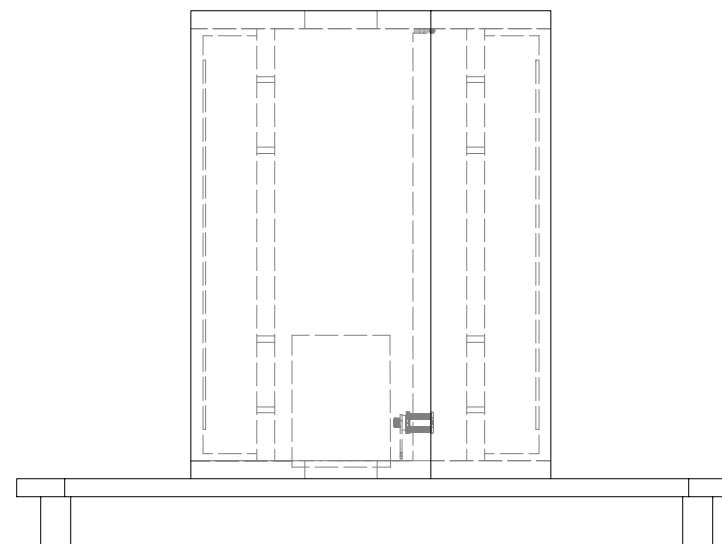
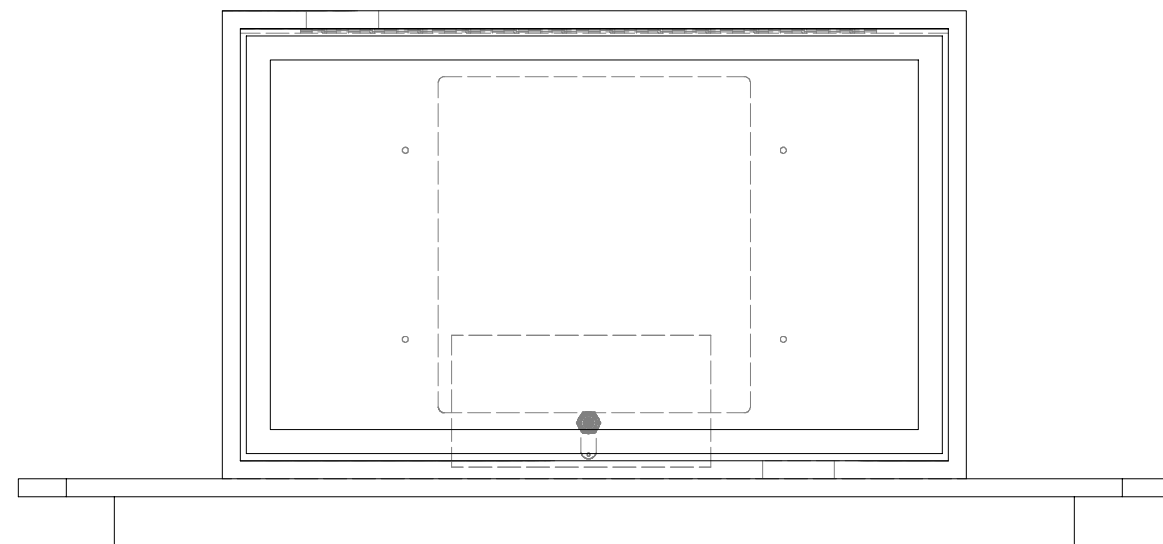
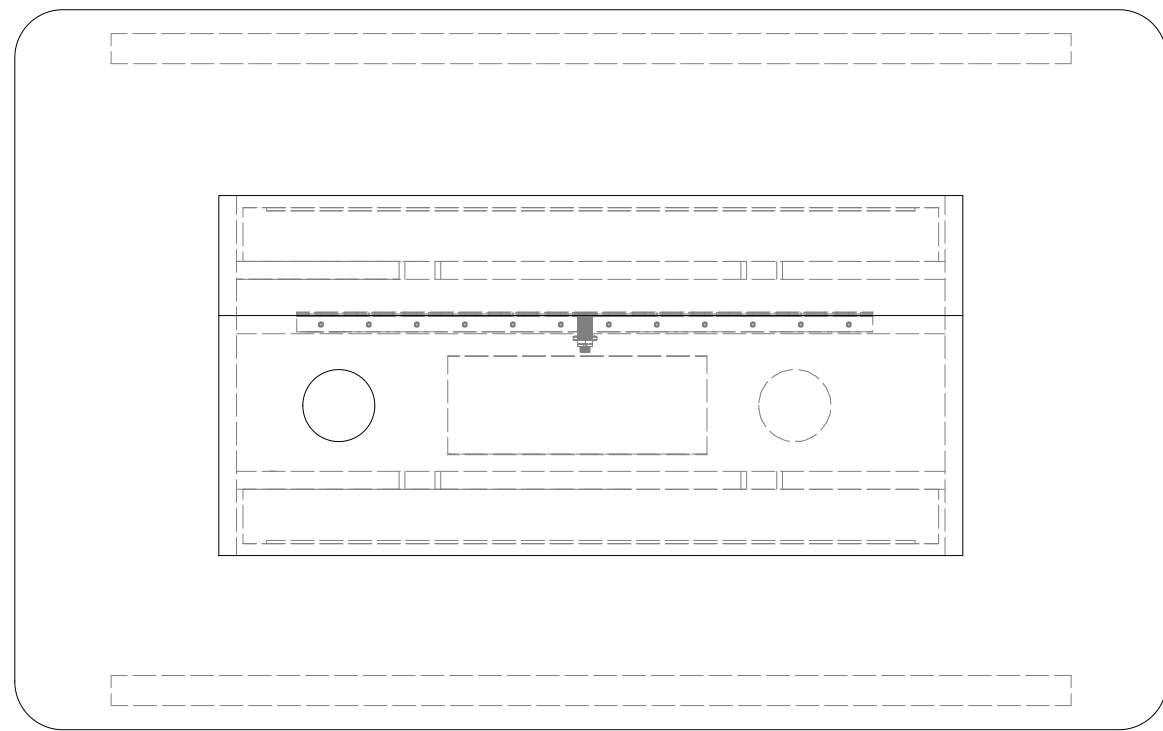

 120 W. KELLOGG, ST. PAUL, MN 55102	EXHIBIT: Run Kiosks	
	DRAWING: Starting Line Kiosk (as-built)	
	PROJECT: Data Visualization Run	DATE: 11/2/18
	DRAWN BY: MDA	1
© 2018 The Science Museum of Minnesota		



 <p><b>Science Museum of Minnesota</b> 120 W. KELLOGG, ST. PAUL, MN 55102</p>	EXHIBIT: Run Kiosks		2
	DRAWING: Make-a-Viz Cabinet (as-built)		
	PROJECT: Data Visualization Run	DATE: 11/2/18	
	DRAWN BY: MDA		
© 2018 The Science Museum of Minnesota			